

Beacham/DelMa

Plan Of Land

In
Boxford, Mass.

Showing
"As-Built Site Conditions"

Lot 57A - Killam Hill Road

Prepared for

Full Circle Construction

Date: December 18, 1998

Zoning District:

R-A - Residence-Agricultural District

This plan has been prepared to accompany a request for
a certificate of compliance to the Boxford
Conservation Commission under DEP File NO.114-620

Assessors Map 16 Block 1 Parcel 10

Note: Property line data taken from a Plan
By Thomas E. Neve Associates, Inc., dated
January 24, 1997


Legend

Existing Grades.	138
100' Wetland Buffer Zone.	140
25' No Cut Zone.	142
Hay Bales.	144
Limit Of Work.	146



837th Sth


Killam Hill Road
(Essex County - Public - 1923
Width Varies)

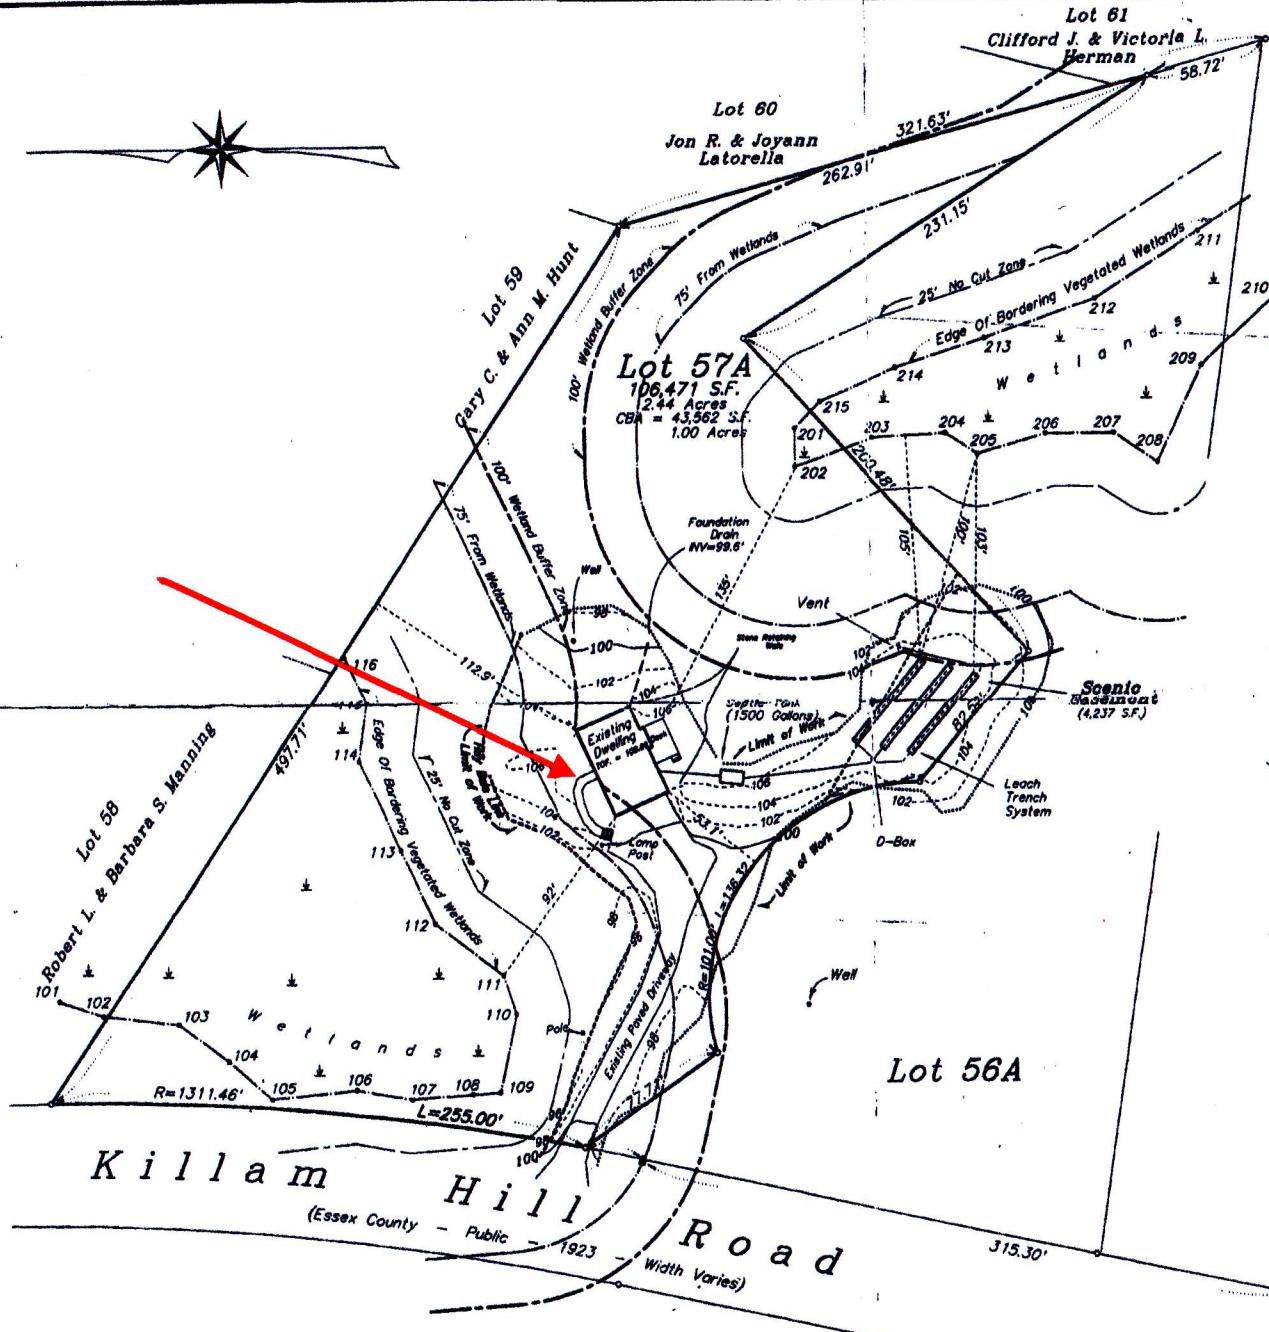

Thomas E. Neve Associates, Inc.
Engineers - Surveyors - Land Use Planners
447 Old Boston Road - U.S. Route 1
Topsfield, Massachusetts 01983 887-8586

1673-CCAB-57A

As-Built Site Conditions
Area in Question
Sketch 1
12/18/98

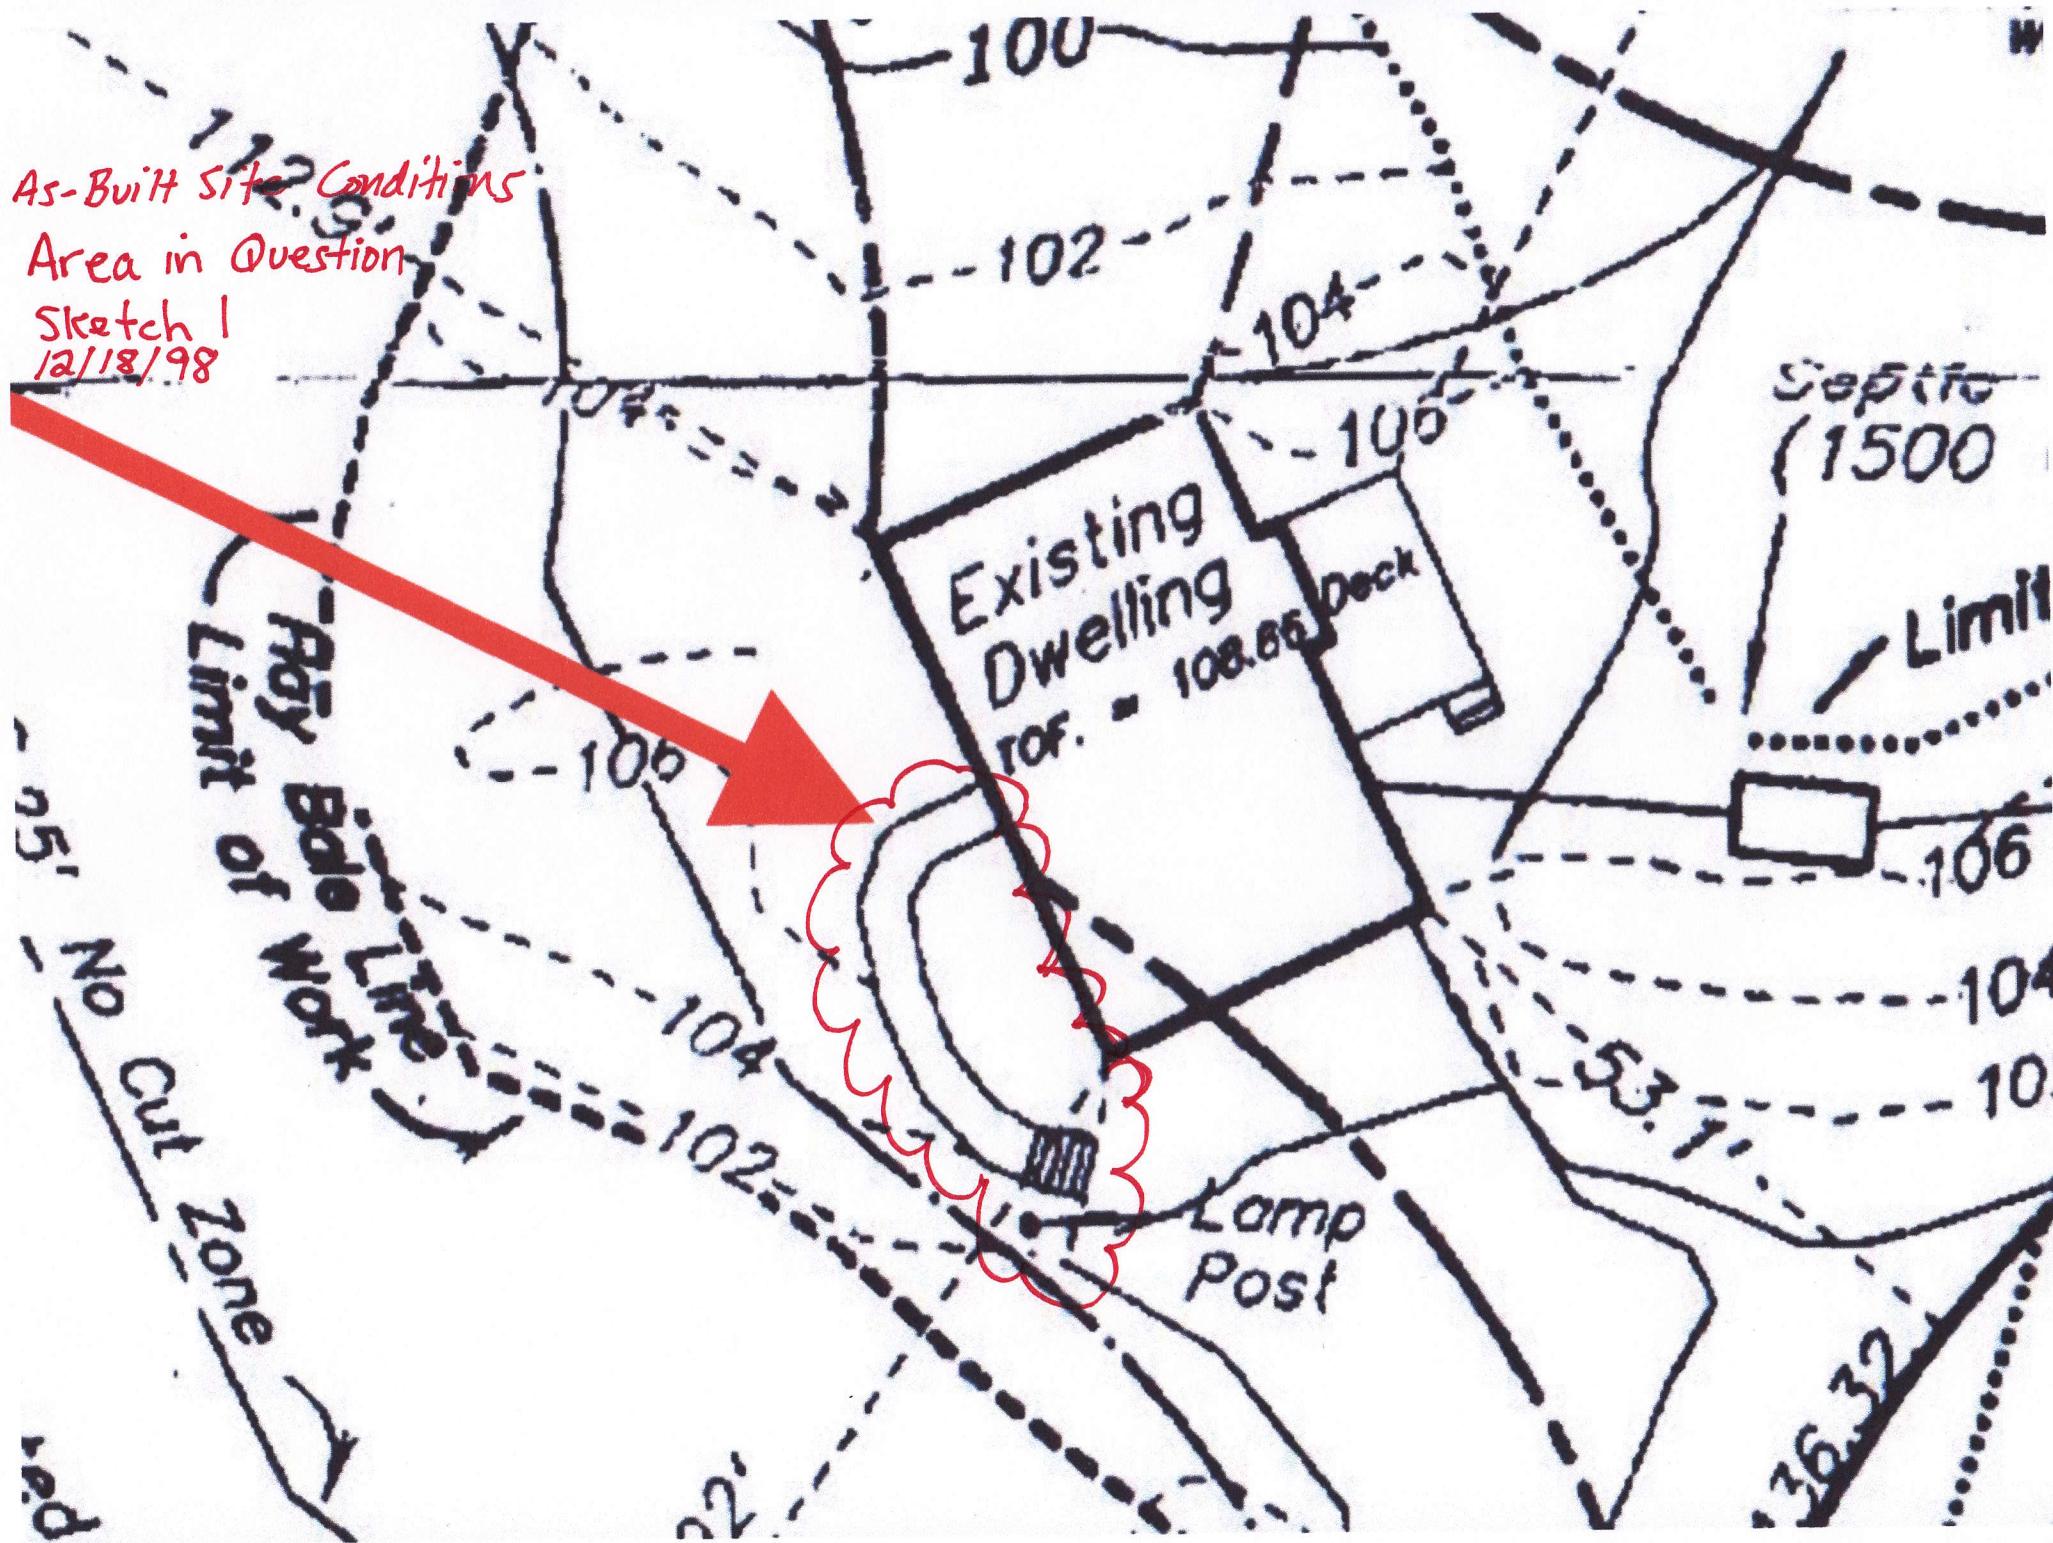


Existing and Proposed Layout Sketch

6/24/22

EXISTING HOUSE = FRONT LANDING? STAIRS.

EXISTING SLOPED WALKWAY

EXISTING FRONT
LANDING AND
STEPS ARE
 $78'' \times 63''$ - TO BE
REBUILT OR REPAIRED
AS NEEDED

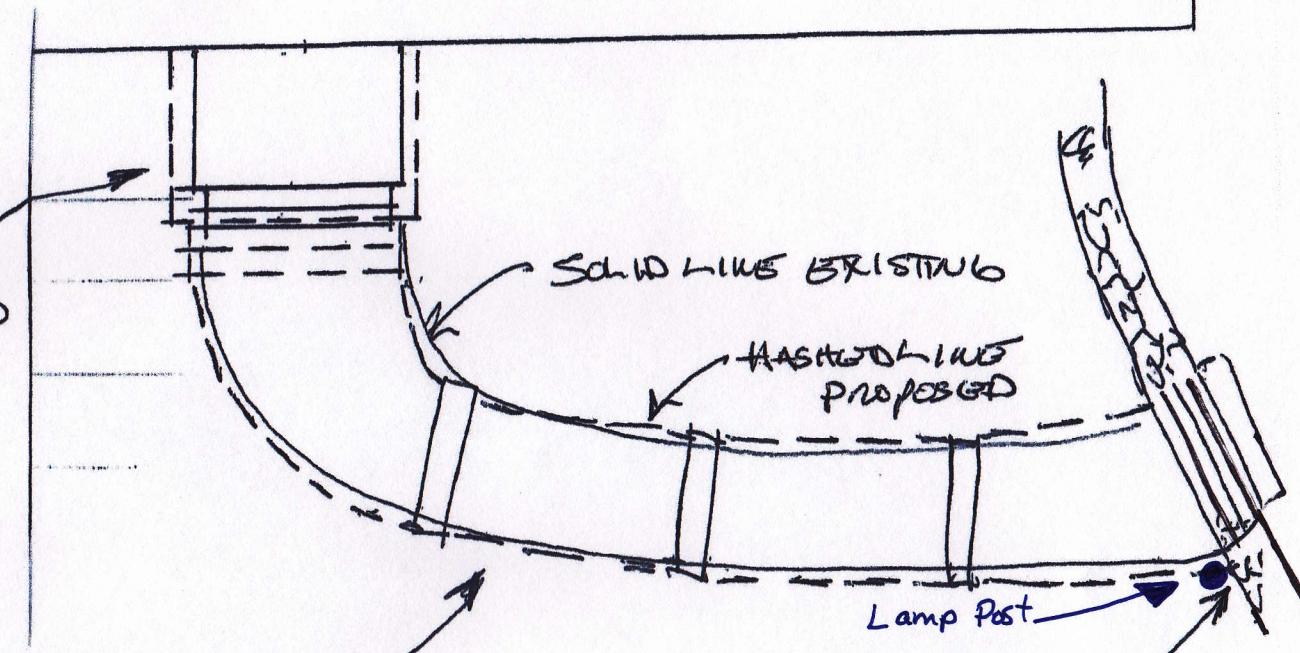

WALKWAY TO BE RECAST IN CONCRETE
ON EXISTING FOOTPRINT ADDING GRANITE
STEPS TO GAGE SLOPES AS NEEDED





EXISTING STONE WALL
TO REMAIN

$\frac{1}{4}'' = 1'$ + -

SK
1

Tree Removal Photos and Collage

6/24/22

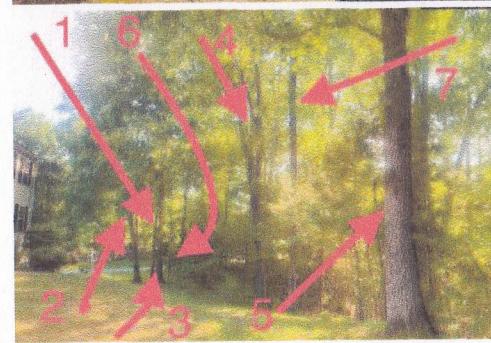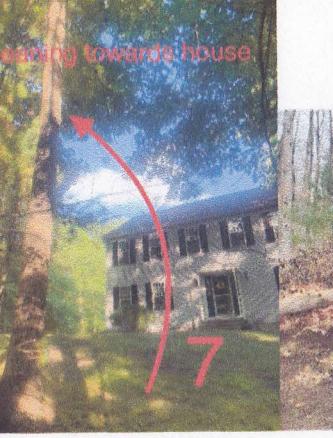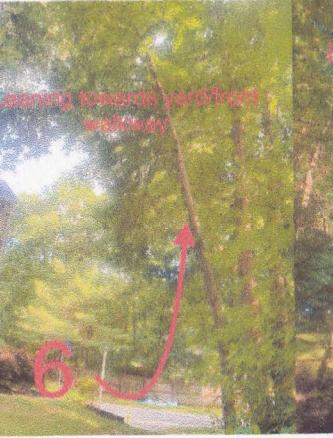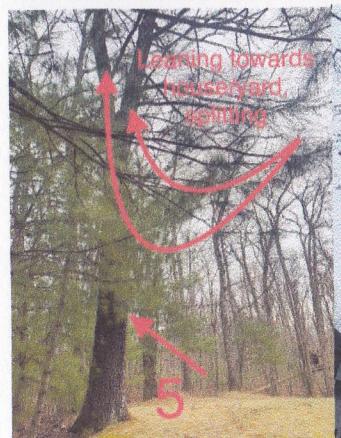

- Note: Reviewed conditions with Greg Gagne/Noble Tree on 05/17/22
- Leanings towards house, yard, front walkway, and/or driveway
- Co/tri dominant or split top (2,3,4,5) and trunk decay (1,4)
- Next to power lines (1,2,3) and many others could hit power lines if limb/tree fall
- Branches/limbs on some of these trees fall during high wind events (see photo of tree that fell through treehouse in wind storm; tree is in same line as trees requested to be removed)
- Close proximity to house has resulted in squirrels gaining easy access to roof; exclusion repairs required after squirrels gained access to attic; close proximity blocks sun resulting in growth and quicker aging of roof on front side of house
- If these trees fall, would damage house and other personal property and more importantly, threaten the safety of my family/children