

ASSESSORS: MAP 31 BLOCK 2 LOT 16A

REFERENCES:

DEED - BK. 36510 PG. 45



PLAN - PL. BK. 430 PL. 73

ORDER OF  
CONDITIONS - BK. 34330 PG. 594

DEP FILE NO.: 114-1210

LEGEND & SYMBOLS

- B BOULDER
- CONC. CONCRETE
- INV. INVERT
- σ UTILITY POLE
- RETAINING WALL

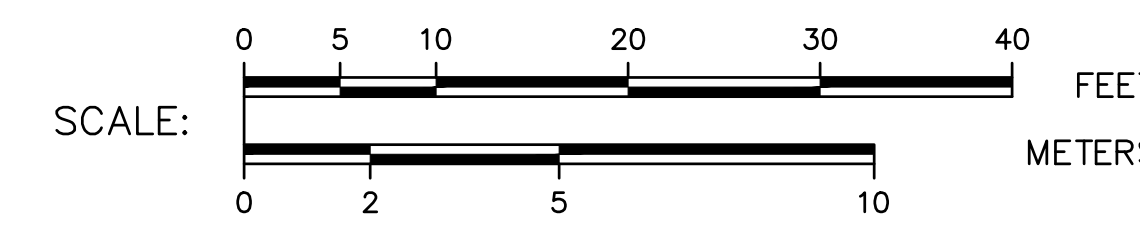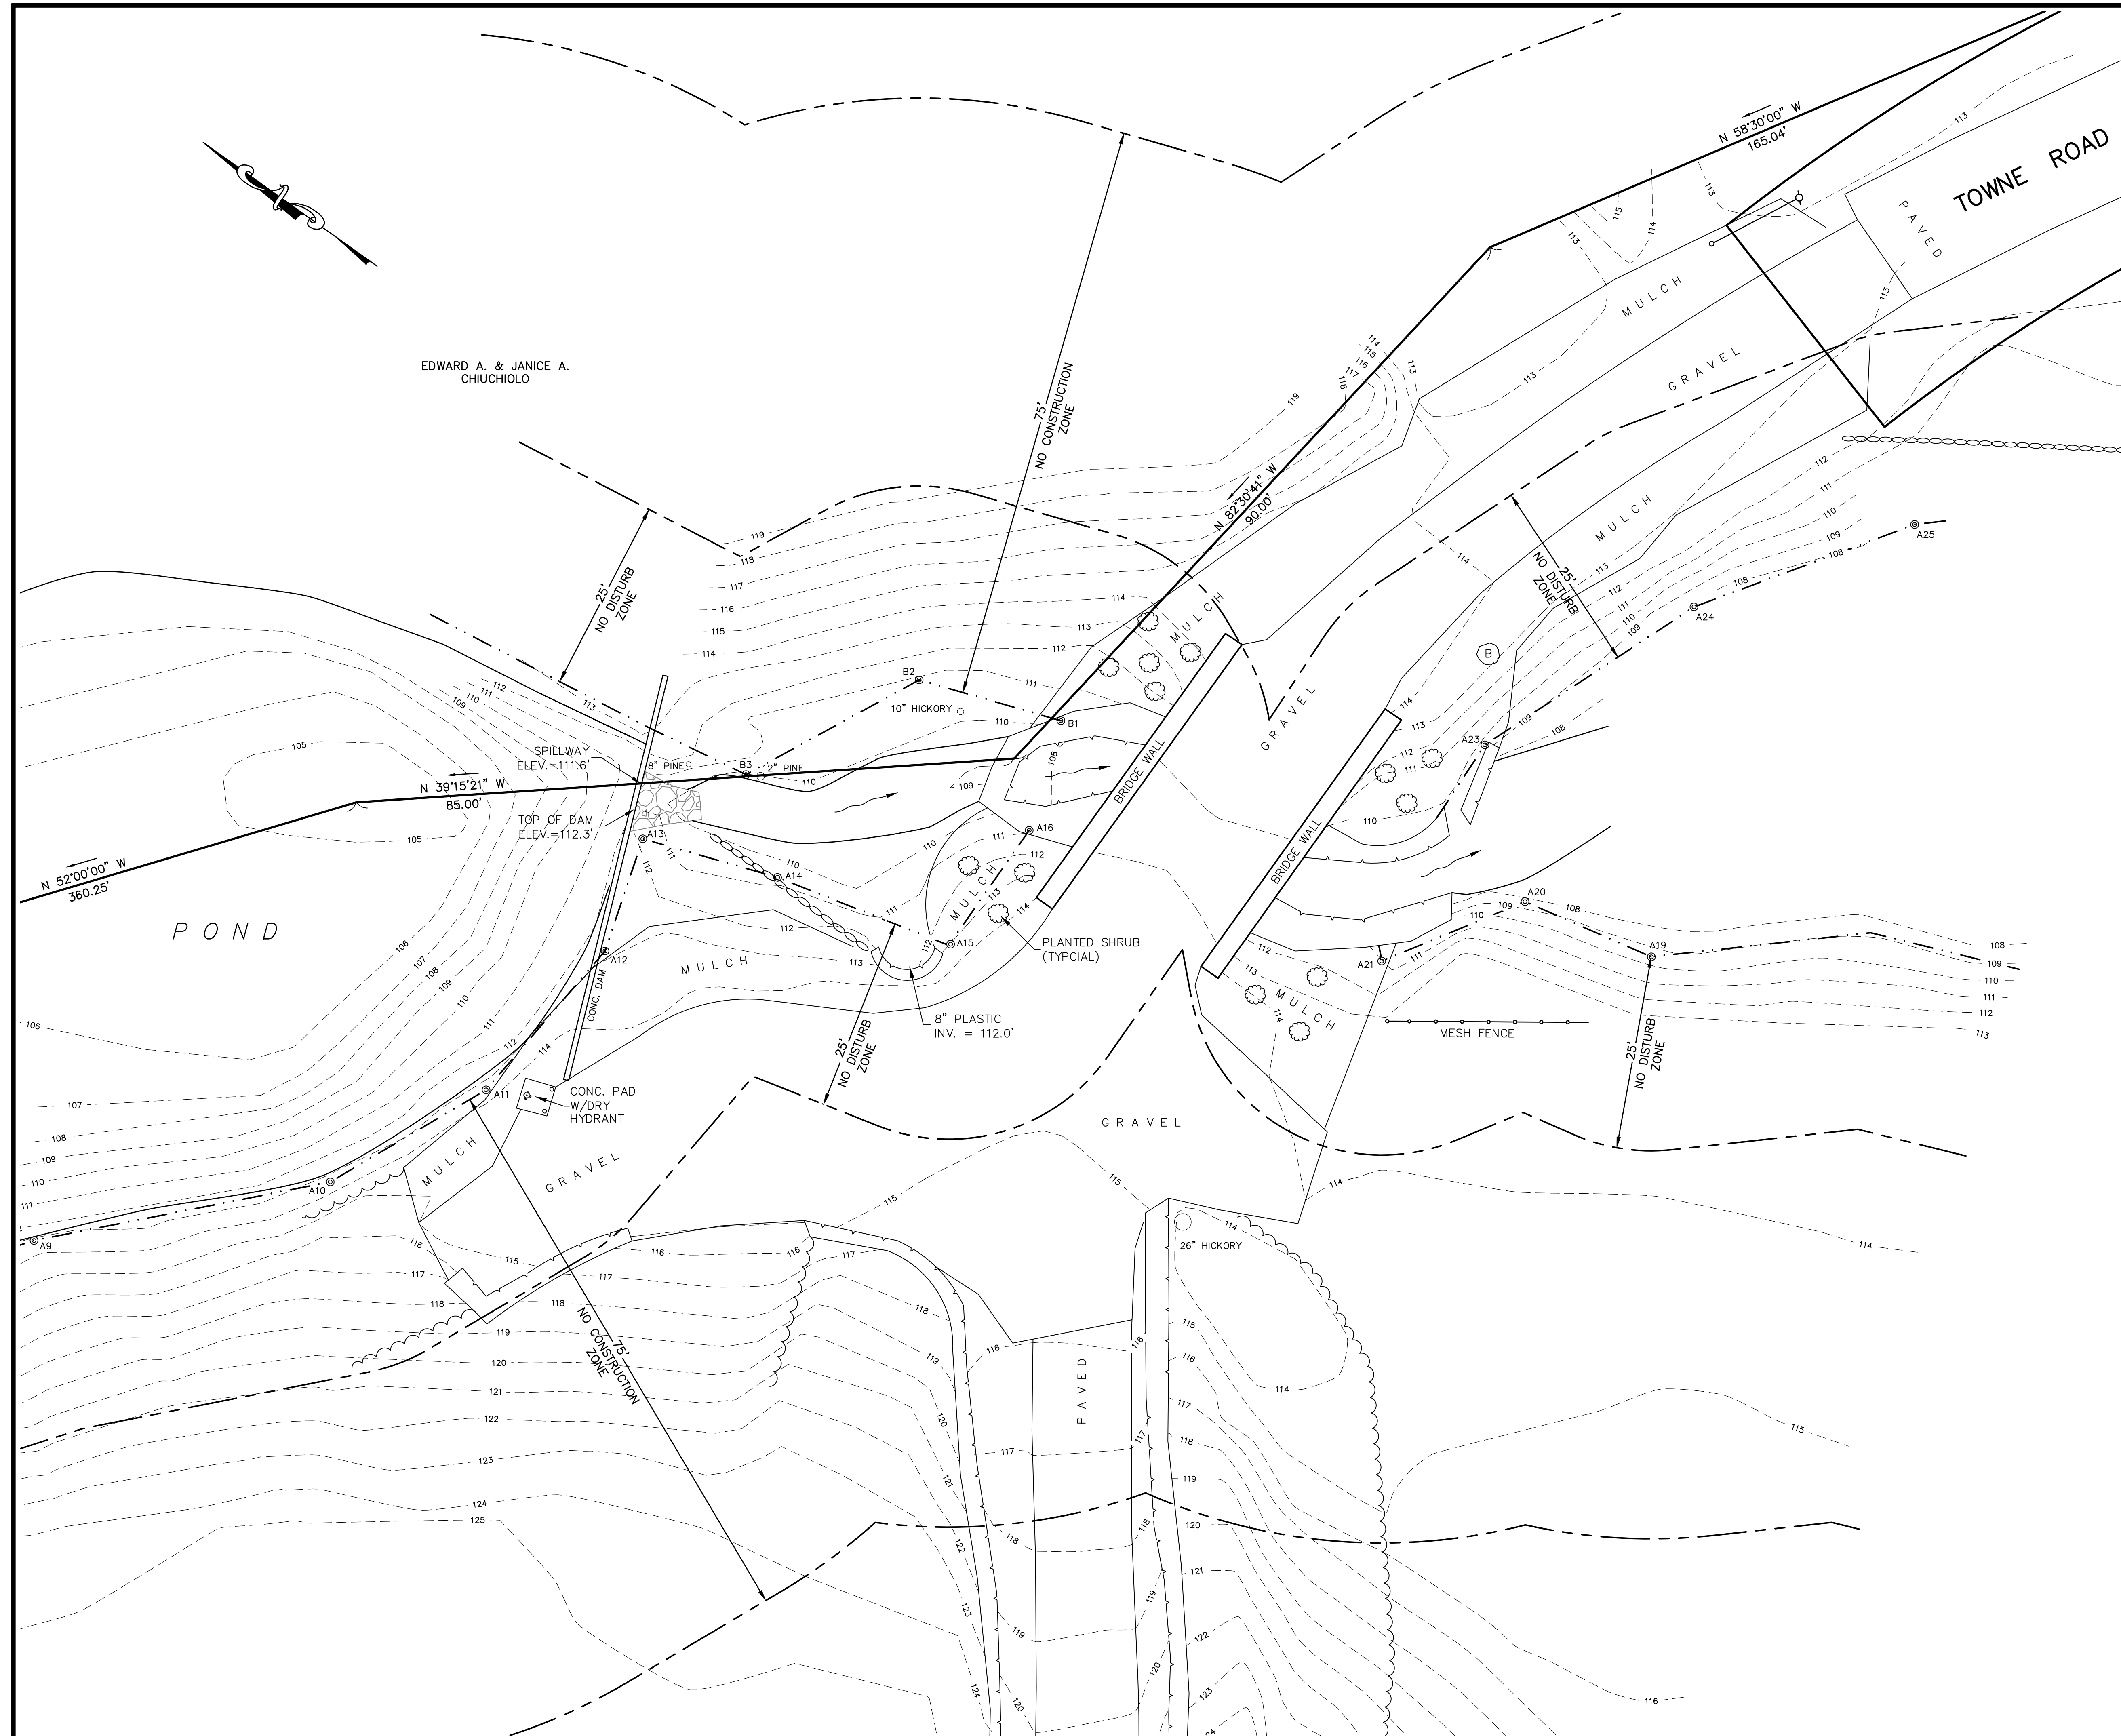

ADDRESS: #55 TOWNE ROAD

AS-BUILT SITE PLAN  
IN  
**BOXFORD, MA**

PROPERTY OF  
**iFARM REALTY, LLC**

SCALE: 1" = 10' NOVEMBER 14, 2018  
**DONOHUE SURVEY, INC.**  
363 BOSTON ST. TOPSFIELD, MA  
(978) 887-6161